

PUBLIC WORKS & UTILITIES COMMITTEE


13-0206R

RESOLUTION AUTHORIZING BILL OF SALE AND TRANSFER
AGREEMENT WITH WLSSD FOR EXCHANGE OF SEWERS.

CITY PROPOSAL: _____

RESOLVED, that the proper city officials are hereby authorized to enter into an agreement with the Western Lake Superior Sanitary District ("WLSSD"), a copy of which is on file in the office of the city clerk as Public Document No. _____, for the transfer of ownership of and responsibility of certain sewer or wastewater lines or pipes and associated manholes and other appurtenances from the city to WLSSD and the transfer of ownership of and responsibility of certain sewer or wastewater lines or pipes and associated manholes and other appurtenances from WLSSD to the city to reflect present practices and the best allocation of responsibility between the parties for the subject facilities.

Approved:

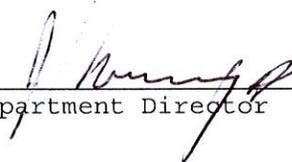


Department Director

Approved for presentation to council:



Chief Administrative Officer

Approved as to form:

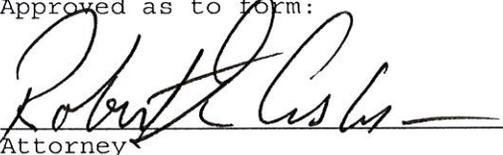

Attorney

Approved:



Auditor

PWU/ATTY REA:db 04/12/2013

STATEMENT OF PURPOSE: This resolution authorizes an agreement with Western Lake Superior Sanitary District ("WLSSD") for the transfer of certain sewer facilities from one party to the other to properly reflect current operating practices and

logical sewer design issues.

When WLSSD was created the intention was that they would take over control and operation of the sewer "interceptors", the major collector sewers, and related facilities and the City would maintain control and operation of the secondary sewer mains and related facilities. Some facilities were inadvertently inappropriately categorized and the result is that the City retained responsibility for some facilities that should have gone to WLSSD and the District got responsibility for some facilities that should have been the City's.

The purpose of this resolution is to rectify that situation with regard to the referenced facilities and to get them into the control of the proper parties.

SHEET 4 (Polk Interceptor)

From WLSSD to Duluth 2,498 feet of various diameter pipe and 14 manholes as shown in red on Sheet 4 appended hereto.

SHEET 5 (Bayview Interceptor)

From WLSSD to Duluth 4,138 feet of 10 inch and 483 of 12 inch VCP and 16 manholes as shown in red on Sheet 5 appended hereto.

SHEET 6 (Rice Lake Interceptor)

From Duluth to WLSSD 3,724 feet of 15 inch RCP and 15 manholes as shown in yellow on Sheet 6 appended hereto.

Each party assumes full liability and responsibility for the Lines which it receives from the other and further agrees to fully indemnify and hold harmless the other for liability of any kind or nature growing out of the ownership or operation of the Pipes received in the Exchange.

CITY OF DULUTH

By: _____
Don Ness, its Mayor

By: _____
City Clerk

WLSSD

By: _____
Chair

By: _____
Marianne Bohren, Executive Director

Interceptor Transfers between City of Duluth and WLSSD Sheet 1 (Woodland and Rice Lake Interceptors)



WLSSD SEWER					
PIPE I.D.	LENGTH	PIPE DIA.	TYPE	YEAR BUILT	CCTV
WL099	27	15"	CONCRETE	1956	2006
WL098	243	15"	CONCRETE	1956	2006
WL097	272	15"	CONCRETE	1956	2006
WL096	24	15"	CONCRETE	1956	2006
WL095	184	15"	CONCRETE	1956	2006
WL094	74	15"	CONCRETE	1956	2006
WL093	260	15"	CONCRETE	1956	2006
WL092	76	15"	CONCRETE	1956	2006
WL091	164	15"	CONCRETE	1956	2006
WL090	329	15"	CONCRETE	1956	2006
WL089	497	15"	CONCRETE	1956	2006
2151		TOTAL FOOTAGE			

RICE LAKE SEWER					
PIPE I.D.	LENGTH	PIPE DIA.	TYPE	YEAR BUILT	CCTV
SA0950050	183	12"	RCP	1991	
SA0950051	366	12"	RCP	1991	
SA0950052	366	12"	RCP	1991	
SD0950053	364	12"	RCP	1991	
SD0950057	367	12"	RCP	1991	
SA0950058	366	12"	RCP	1991	
SD0950060	362	12"	RCP	1991	
SD0950061	271	12"	RCP	1991	
SA0910014	328	12"	RCP	1991	
SA0910015	69	12"	RCP	1991	
SA0910016	320	12"	RCP	1991	
SA0910017	89	12"	RCP	1991	
SA0910018	178	12"	RCP	1991	
SA0910019	327	12"	RCP	1991	
SA0910020	490	12"	RCP	1991	
SA0910021	14	12"	RCP	1991	
4460		TOTAL FOOTAGE			

Transfer the following interceptor gravity sewers:
 4460' of 12" RCP and 16 manholes from Duluth to WLSSD
 2151' of 15" RCP and 11 manholes from WLSSD to Duluth

Map Legend

- WLSSD manholes to Duluth
- Duluth manholes to WLSSD
- ▬ WLSSD sewer to Duluth
- ▬ Duluth sewer to WLSSD
- ~ Streams



Interceptor Transfers between City of Duluth and WLSSD Sheet 2 (Lincoln Park Neighborhood)


Transfer the following interceptor gravity sewer:
373' of 21" pipe and two manholes from WLSSD to Duluth

Map Legend

- WLSSD manholes to Duluth
- ~ WLSSD sewer to Duluth
- Roads




Copyright September 18, 2012

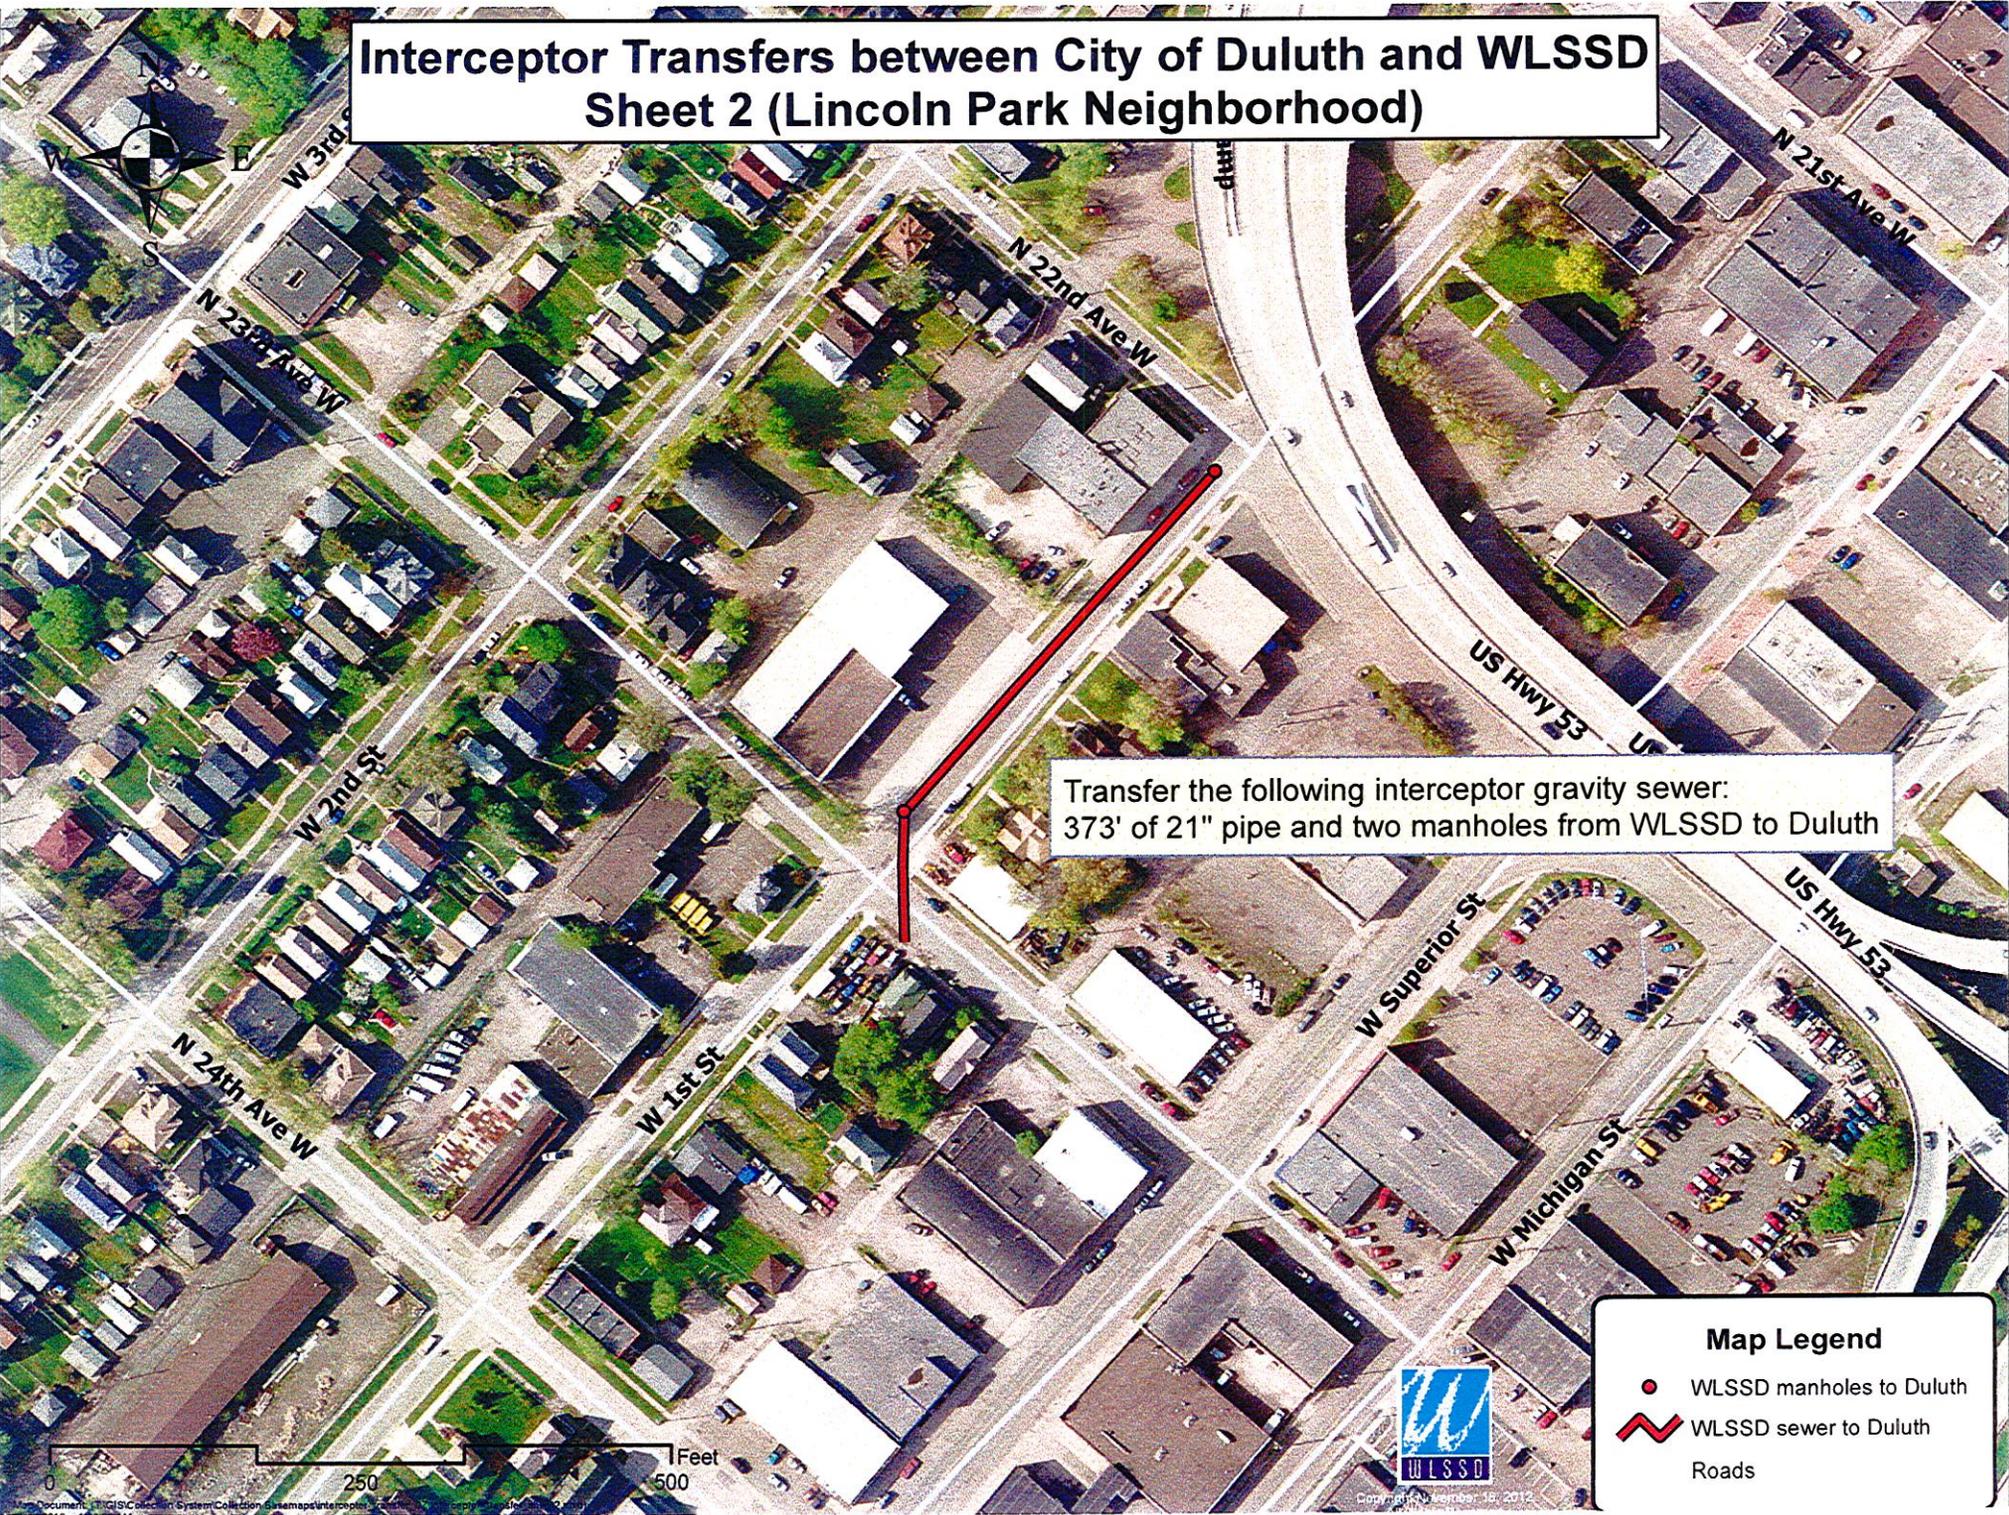

Interceptor Transfers between City of Duluth and WLSSD Sheet 3 (Menards Area)

Transfer the following interceptor gravity sewers:
828' of 10" PVC and 7 manholes from WLSSD to Duluth

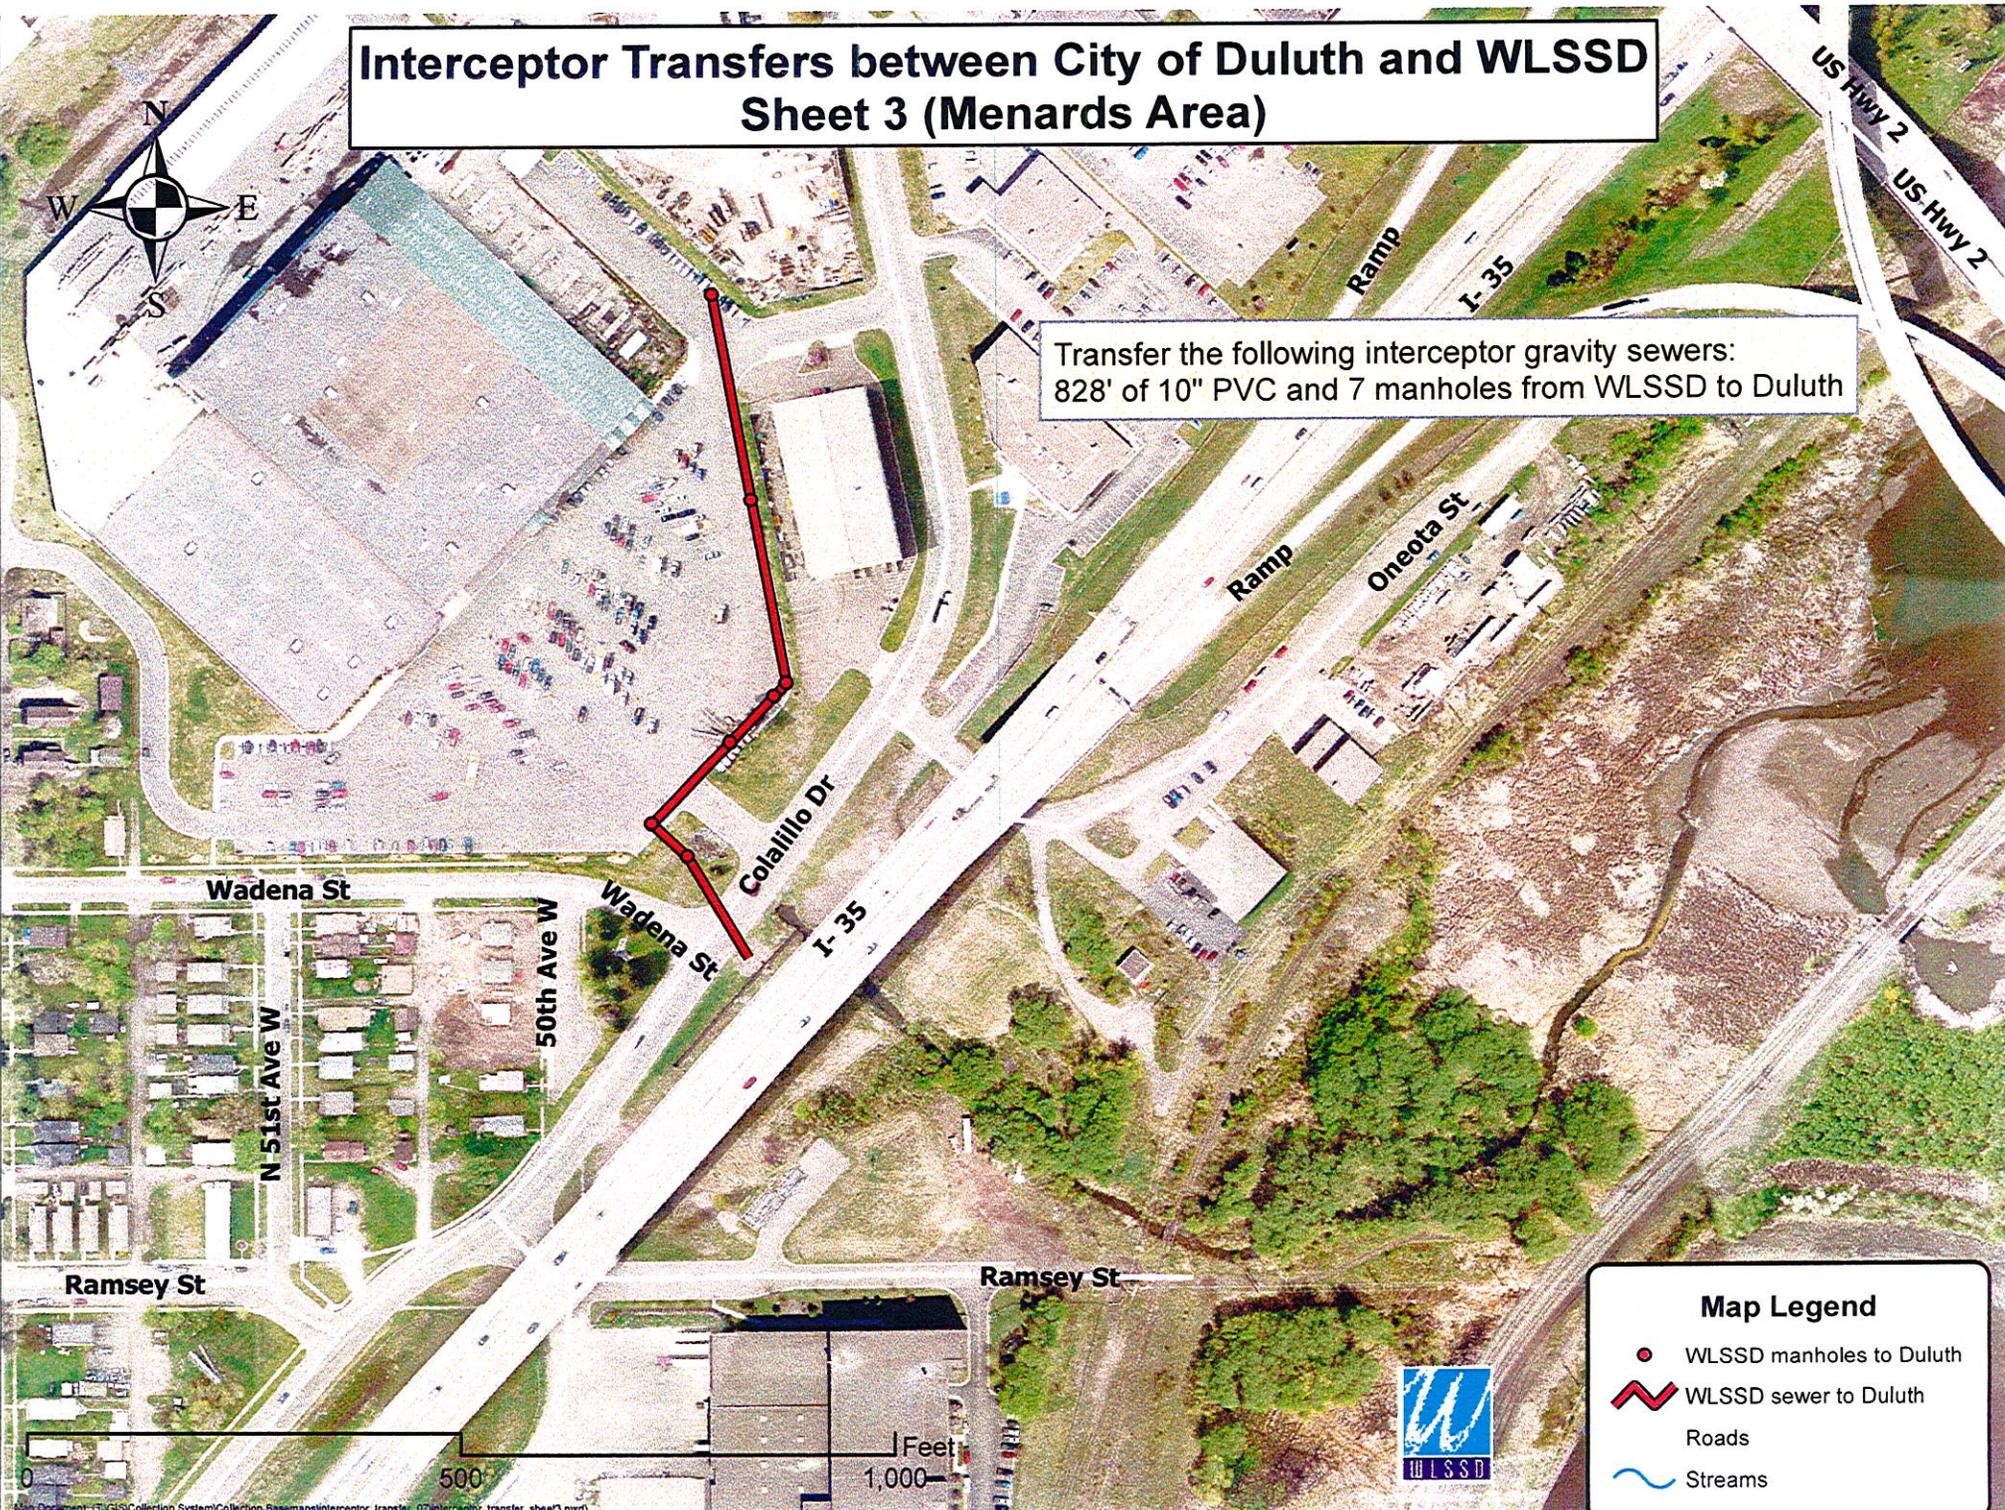


Map Legend

- WLSSD manholes to Duluth
- WLSSD sewer to Duluth
- Roads
- Streams

Interceptor Transfers between City of Duluth and WLSSD Sheet 4 (Polk Interceptor)

Transfer the following interceptor gravity sewers:
2498' of various diameter pipe and 14 manholes
from WLSSD to Duluth (line was CIPP in 2004)

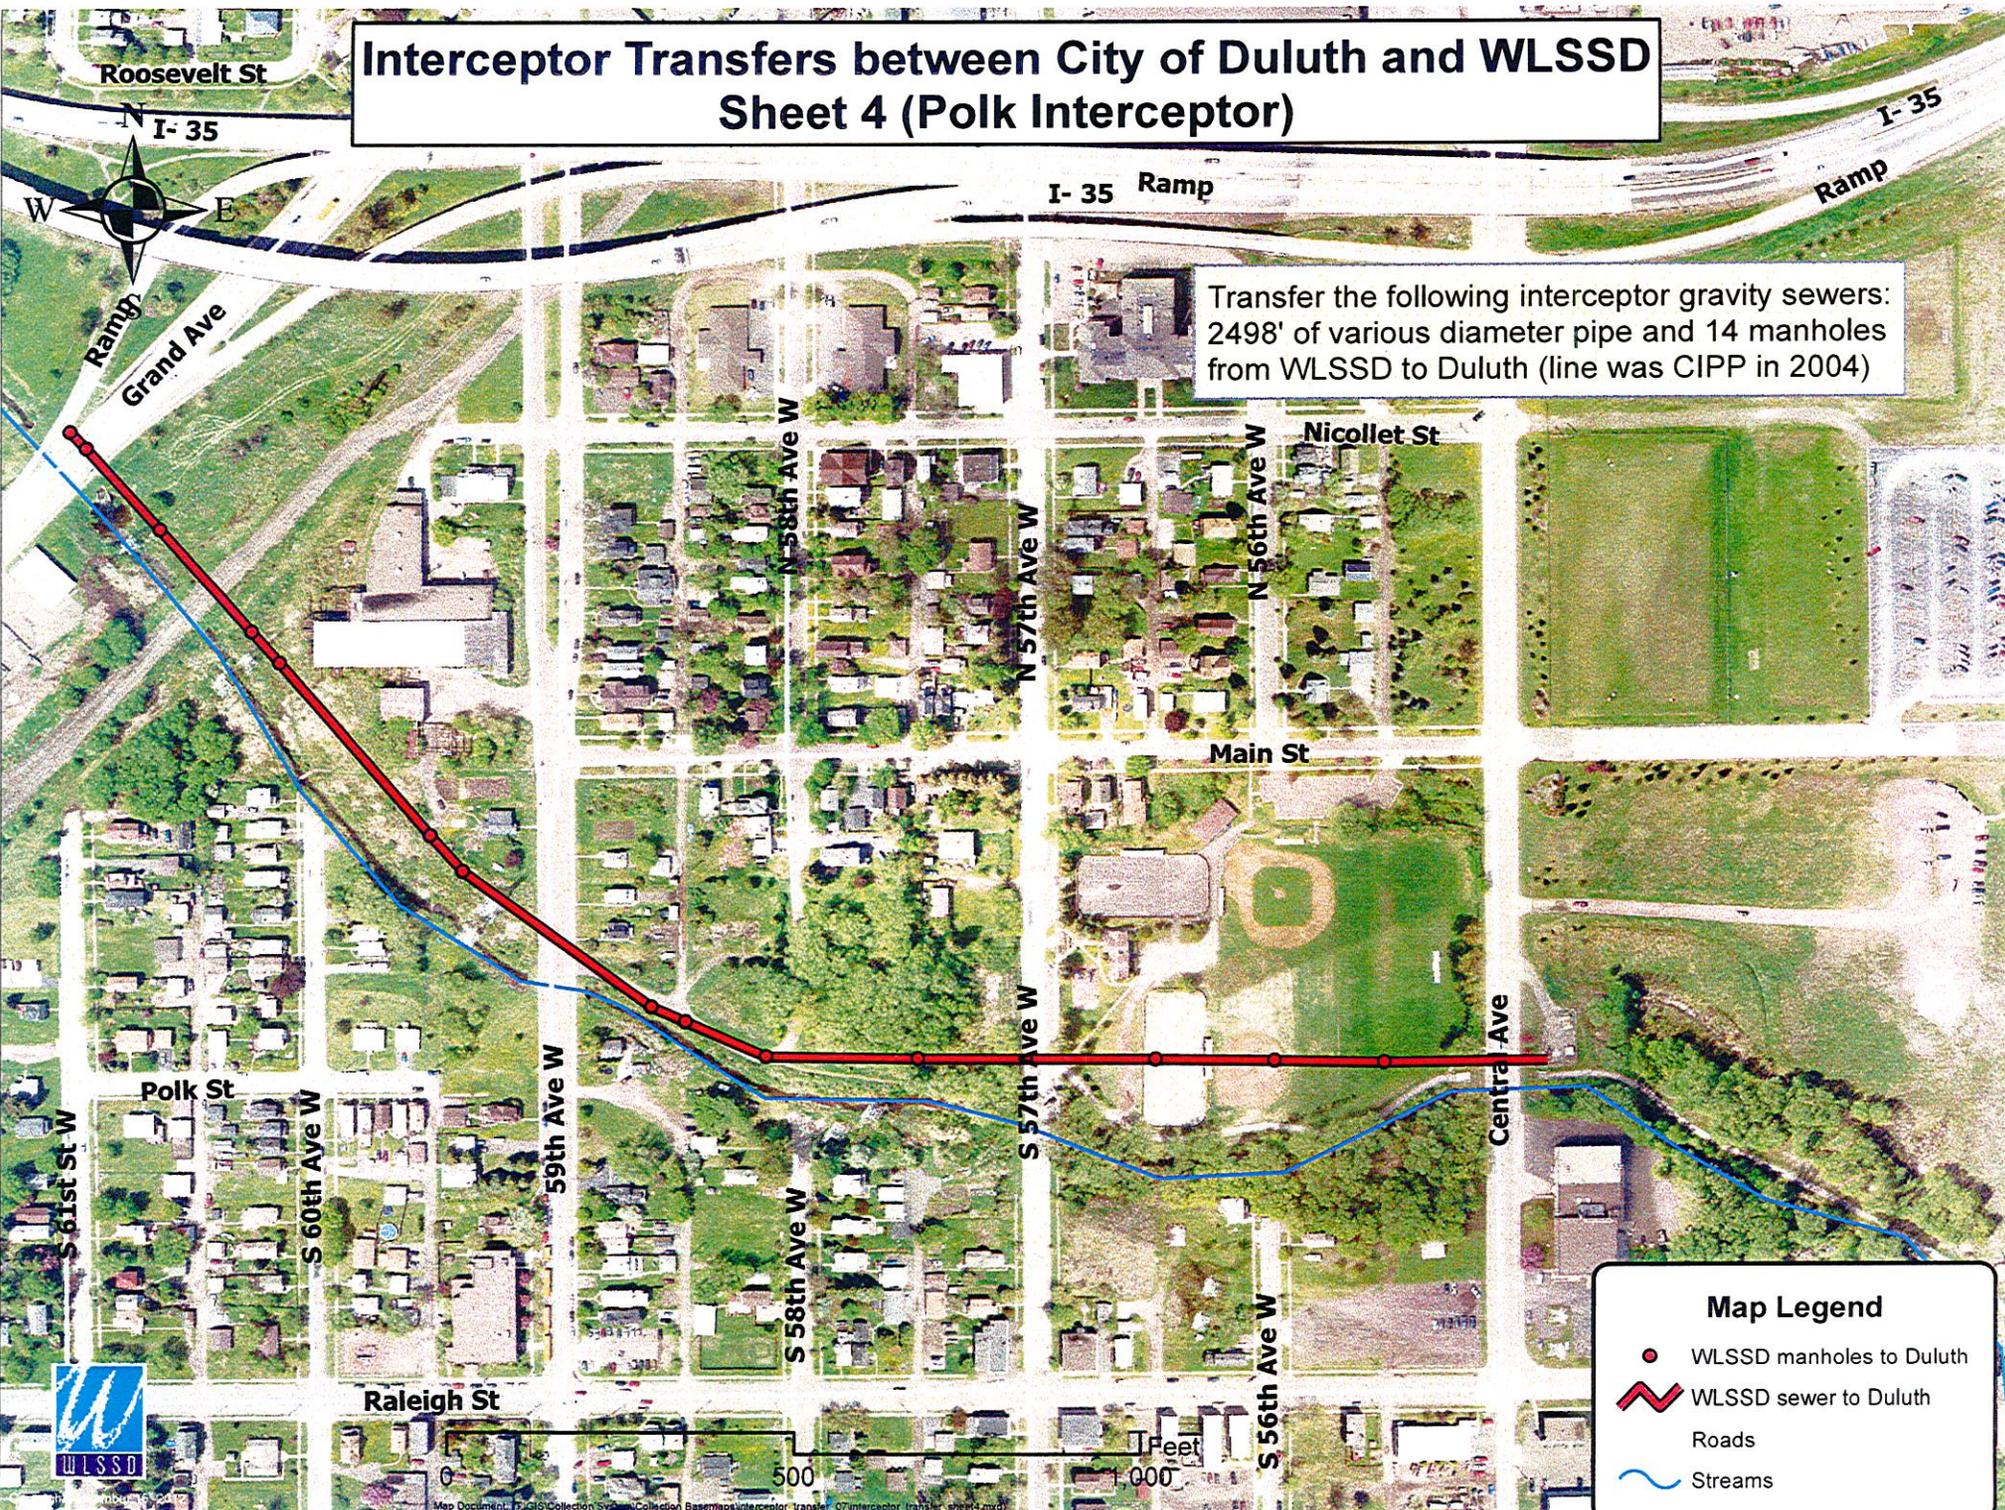

Map Legend


- WLSSD manholes to Duluth
- WLSSD sewer to Duluth
- Roads
- Streams



Interceptor Transfers between City of Duluth and WLSSD Sheet 5 (Bayview Interceptor)



Transfer the following interceptor gravity sewers:
4138' of 10" and 483' of 12" pipe and
16 manholes from WLSSD to Duluth

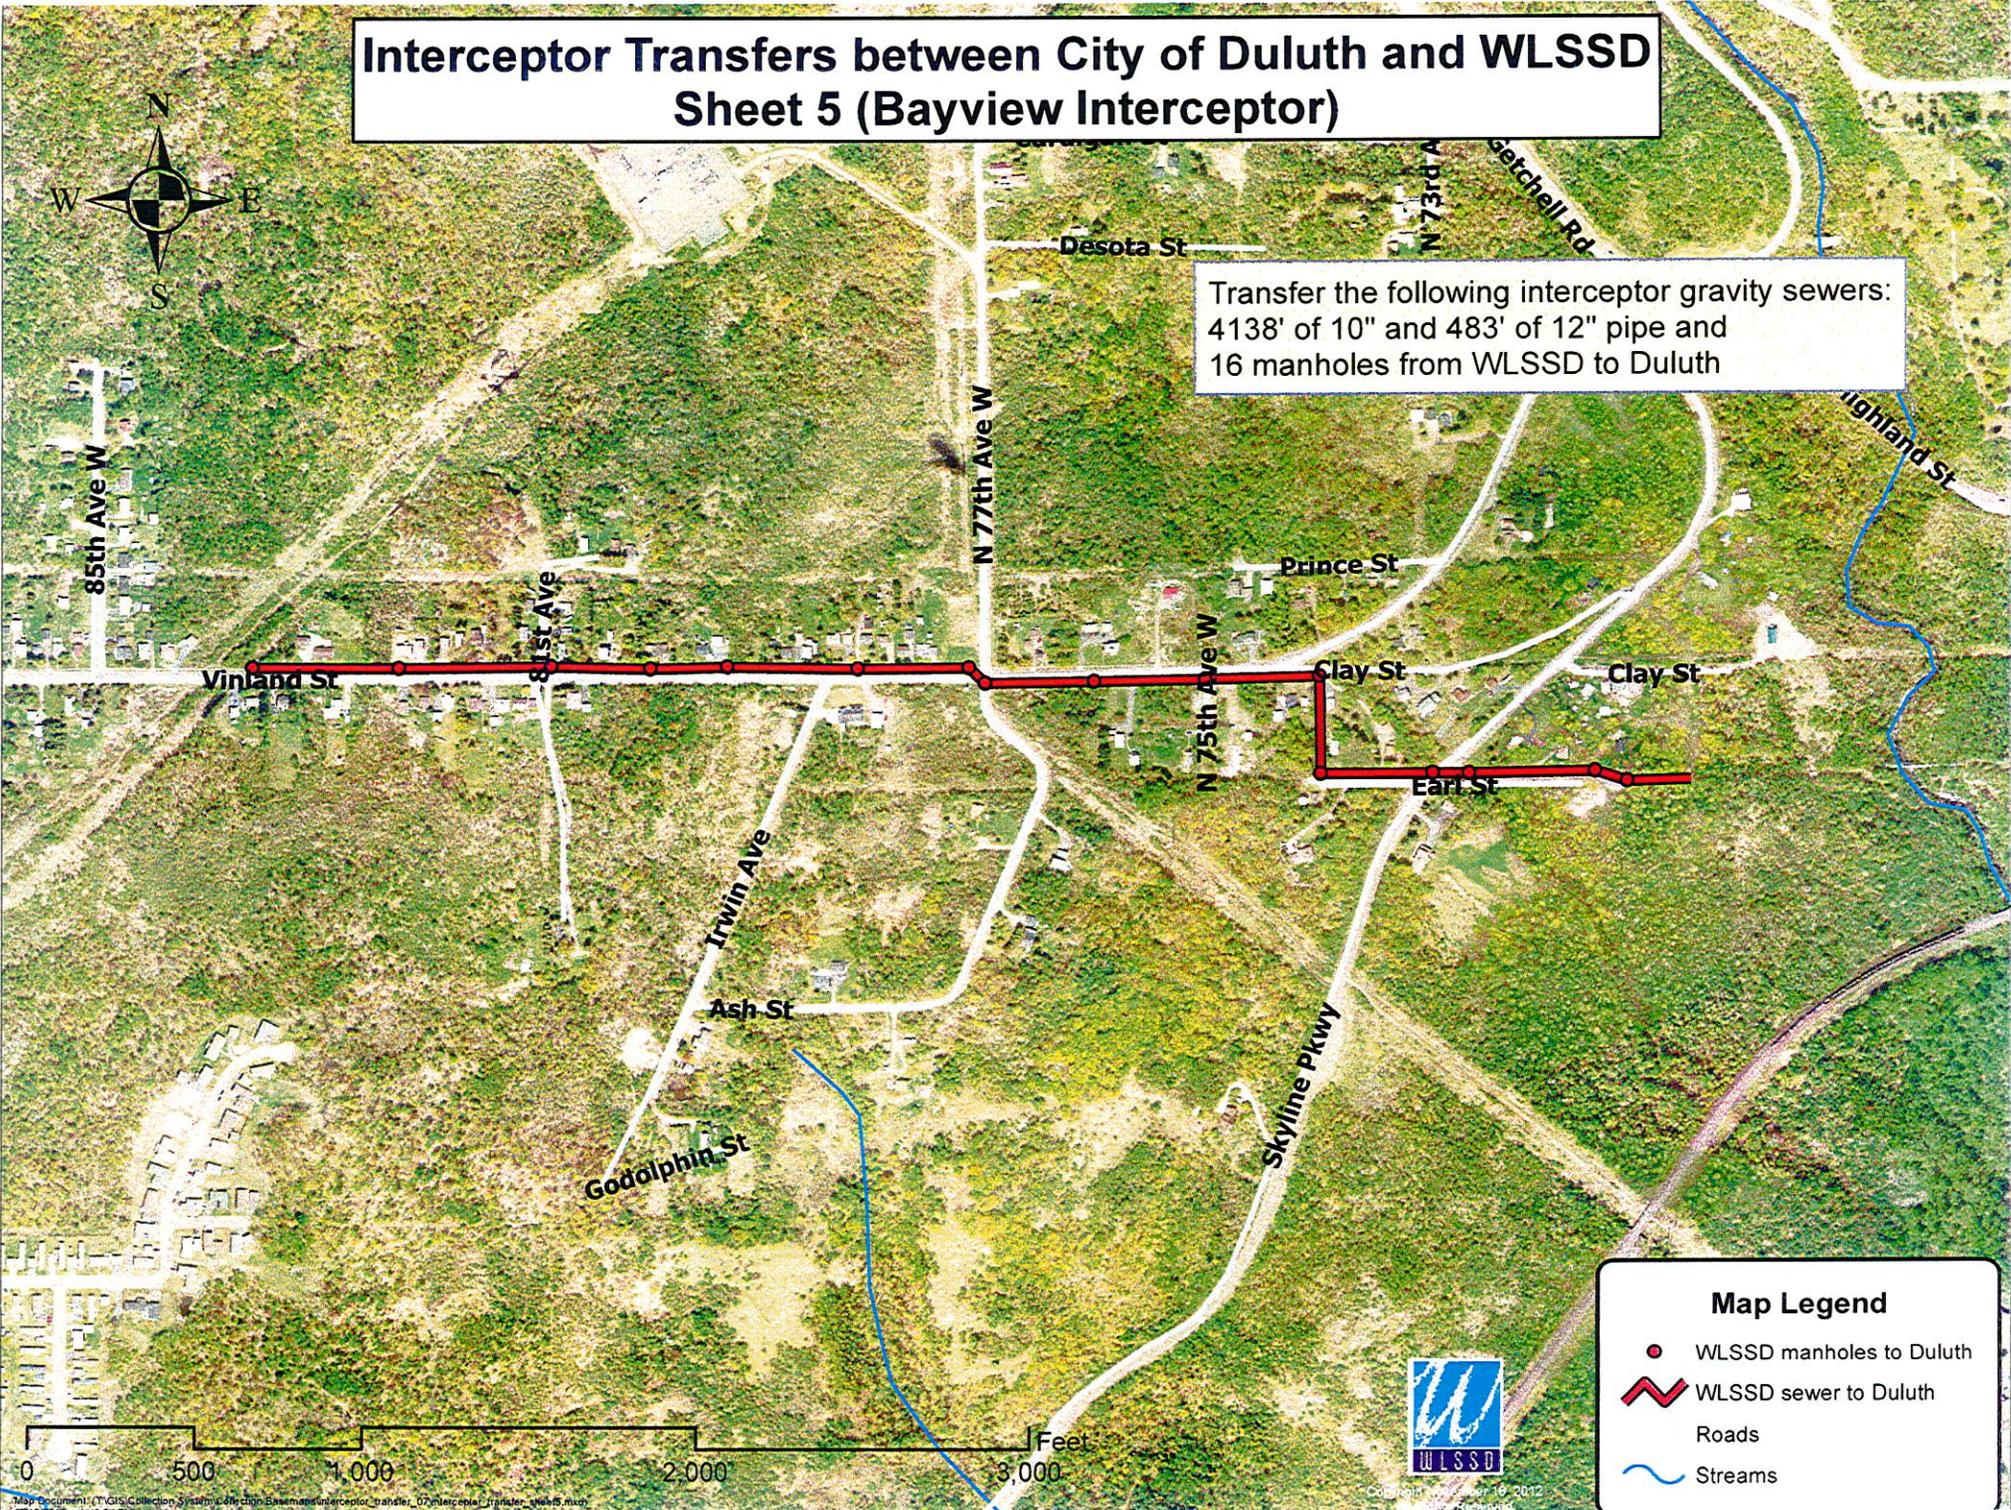


Map Legend

- WLSSD manholes to Duluth
- WLSSD sewer to Duluth
- Roads
- ~ Streams



Interceptor Transfers between City of Duluth and WLSSD Sheet 6 (Rice Lake Interceptor)

Transfer the following interceptor gravity sewers:
3776' of 15" pipe and 15 manholes from Duluth to WLSSD

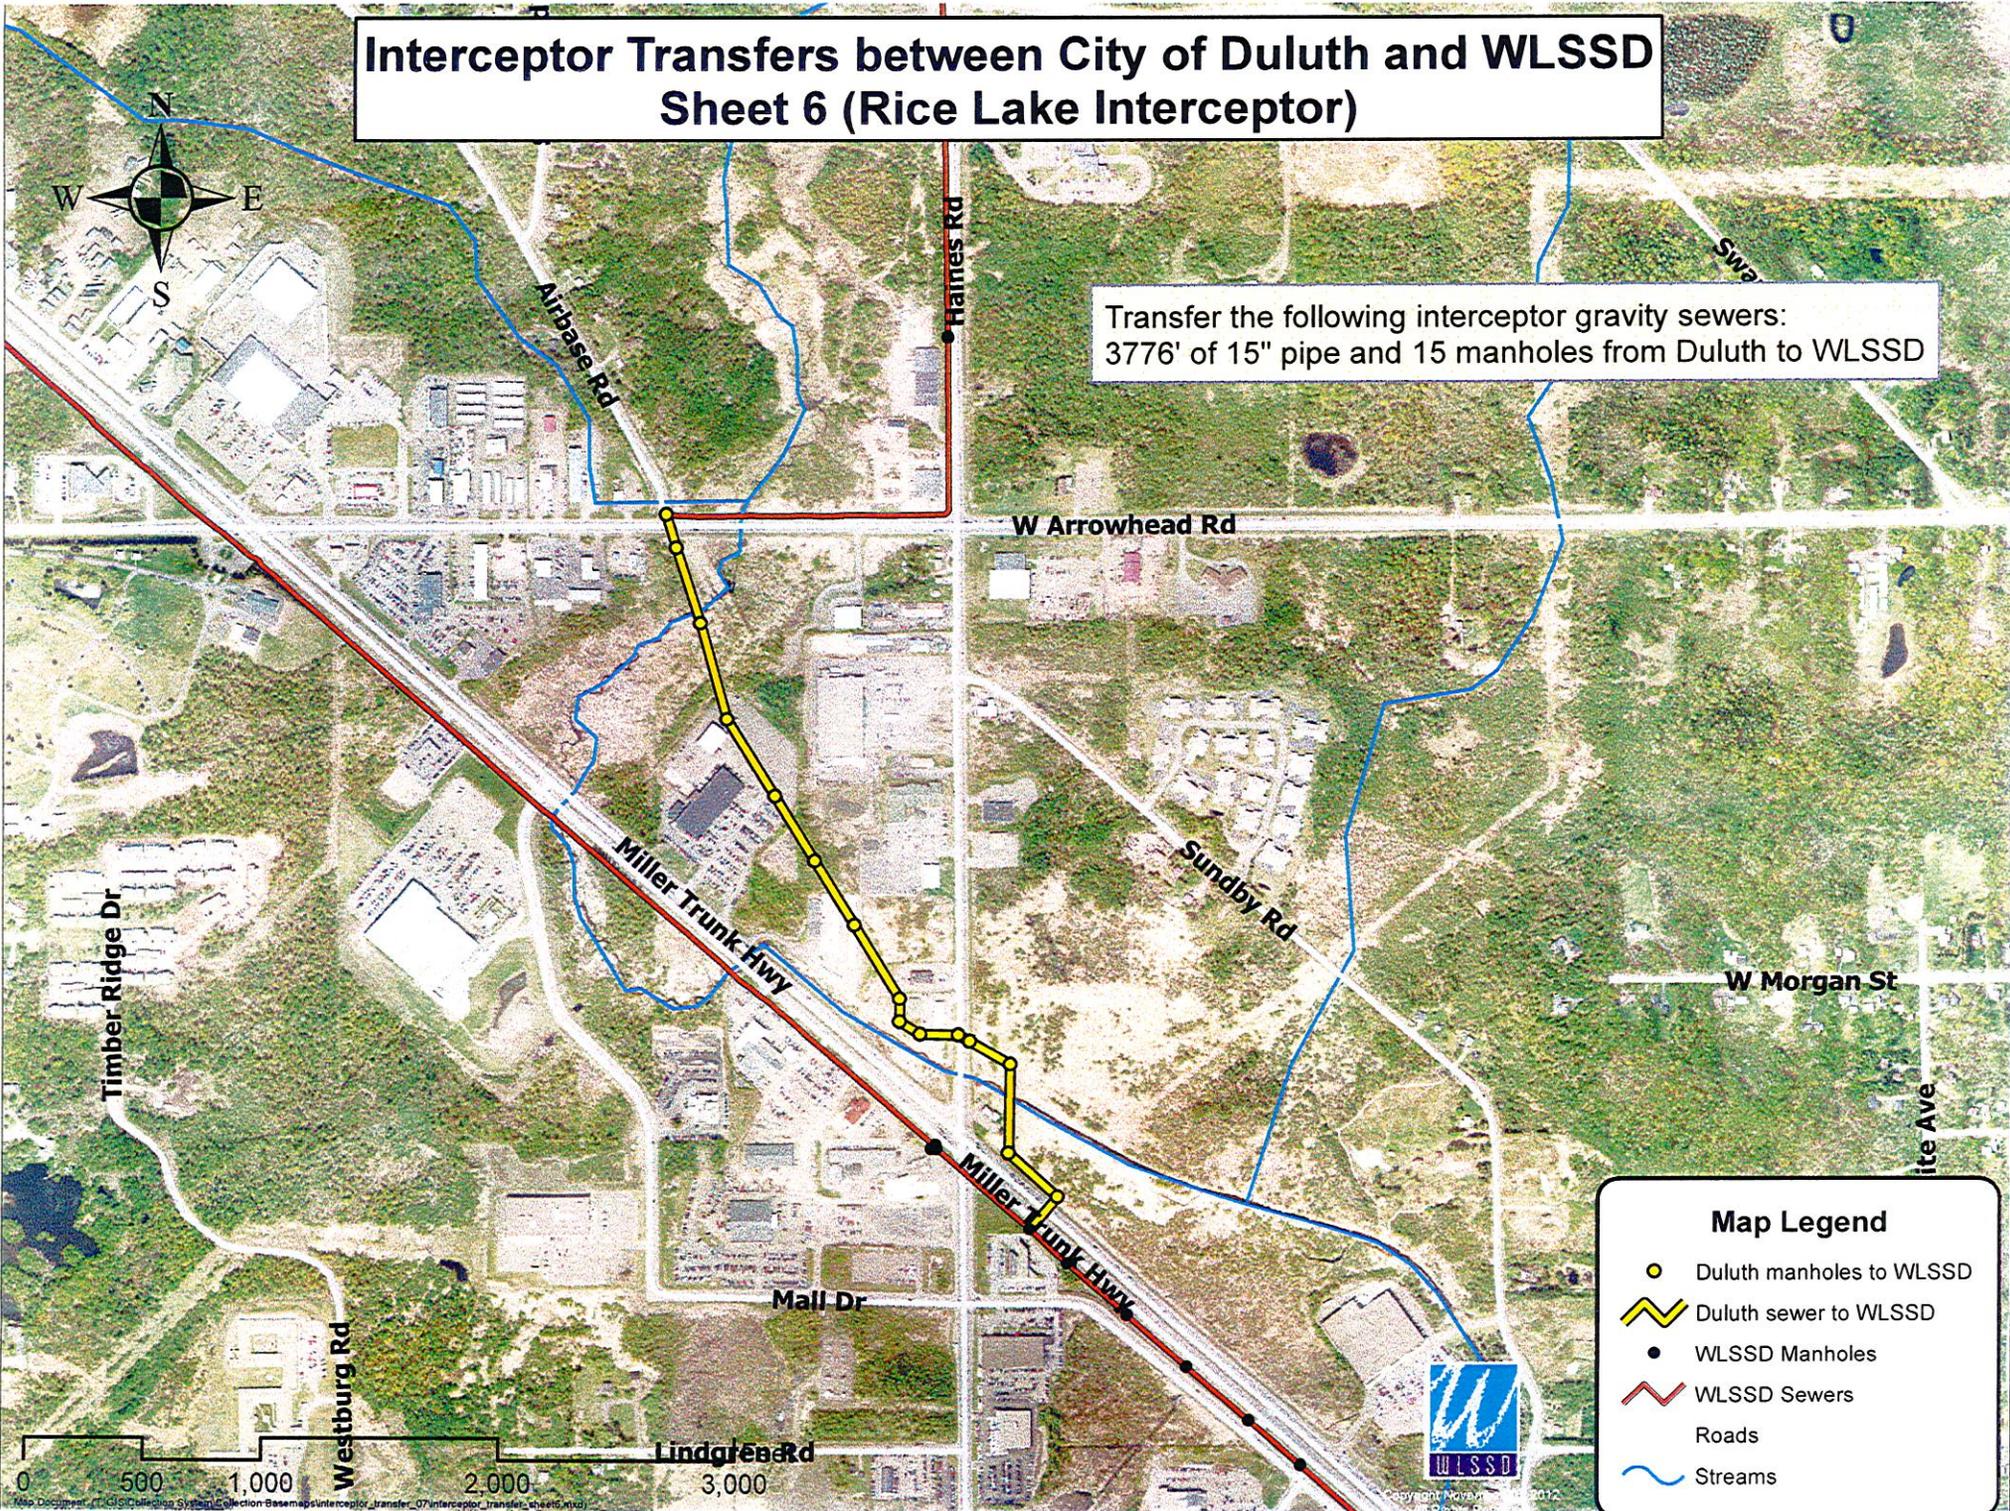

Map Legend

- Duluth manholes to WLSSD
- Duluth sewer to WLSSD
- WLSSD Manholes
- WLSSD Sewers
- Roads
- Streams

Map Document: C:\GIS\Collector\Systems\Collector\Basemap\Interceptor_Transfer_07\Interceptor_Transfer_07.mxd

Copyright: November 2012